LET	DATE	E.C.N.	REVISION RECORD	BY

March of Dimes

Alternations

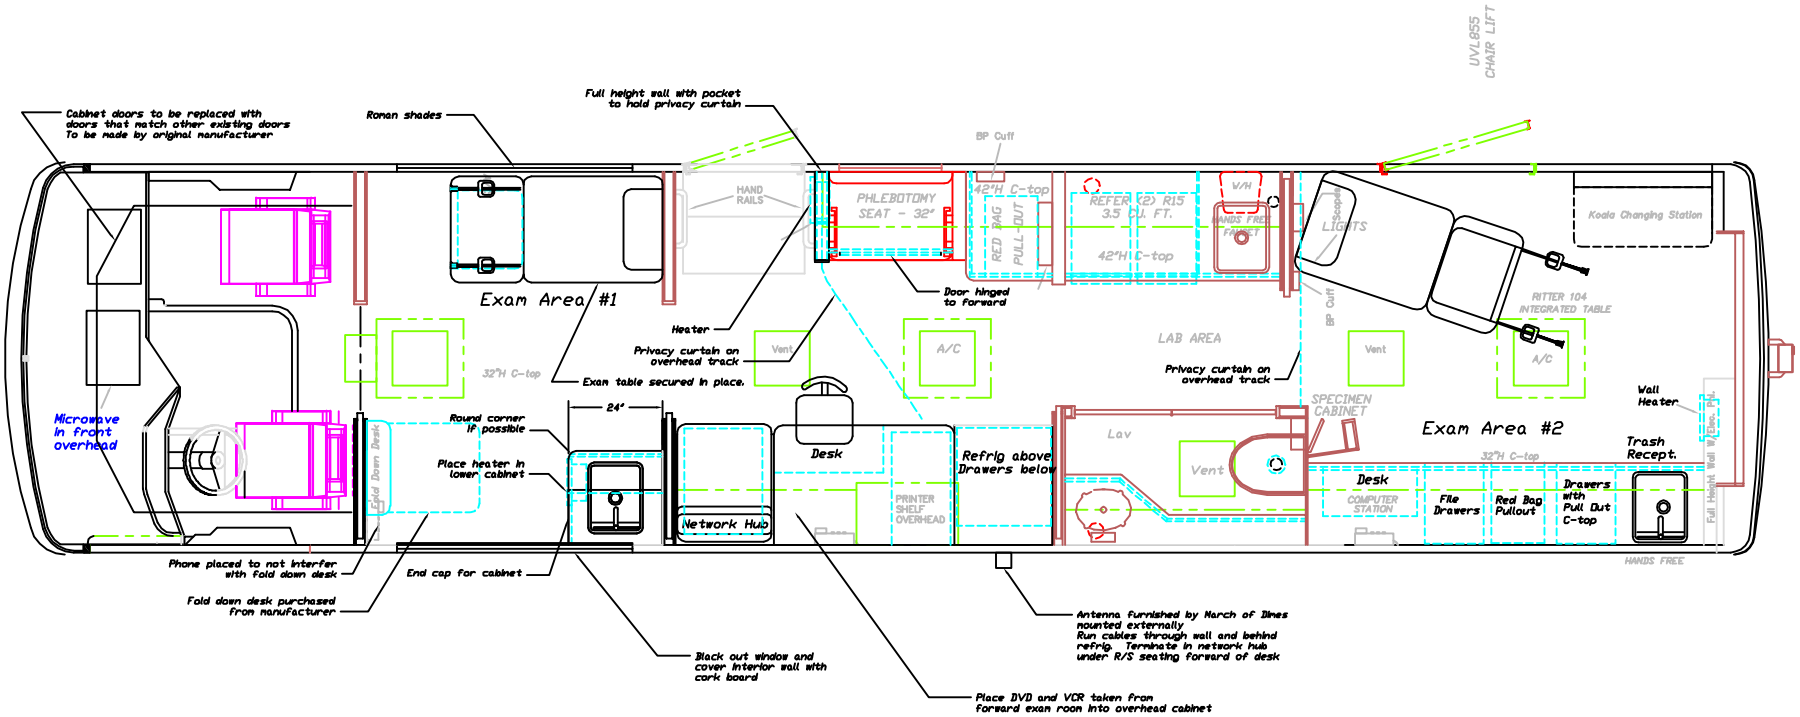

Mobile Medical & Command Center Vehicles ®

ITEM	PART NUMBER	DESCRIPTION	QTY	UM

TOLERANCES | NEXT ASS'Y | FIRST USAGE: PRODUCT

Airstream

DRAWN BY: TVN | APPROVED BY: DSA

TITLE: March of Dimes

SCALE	DATE	DRAWING NUMBER		REV.
1=16	3/01/07	Gas 37XL	D	4